
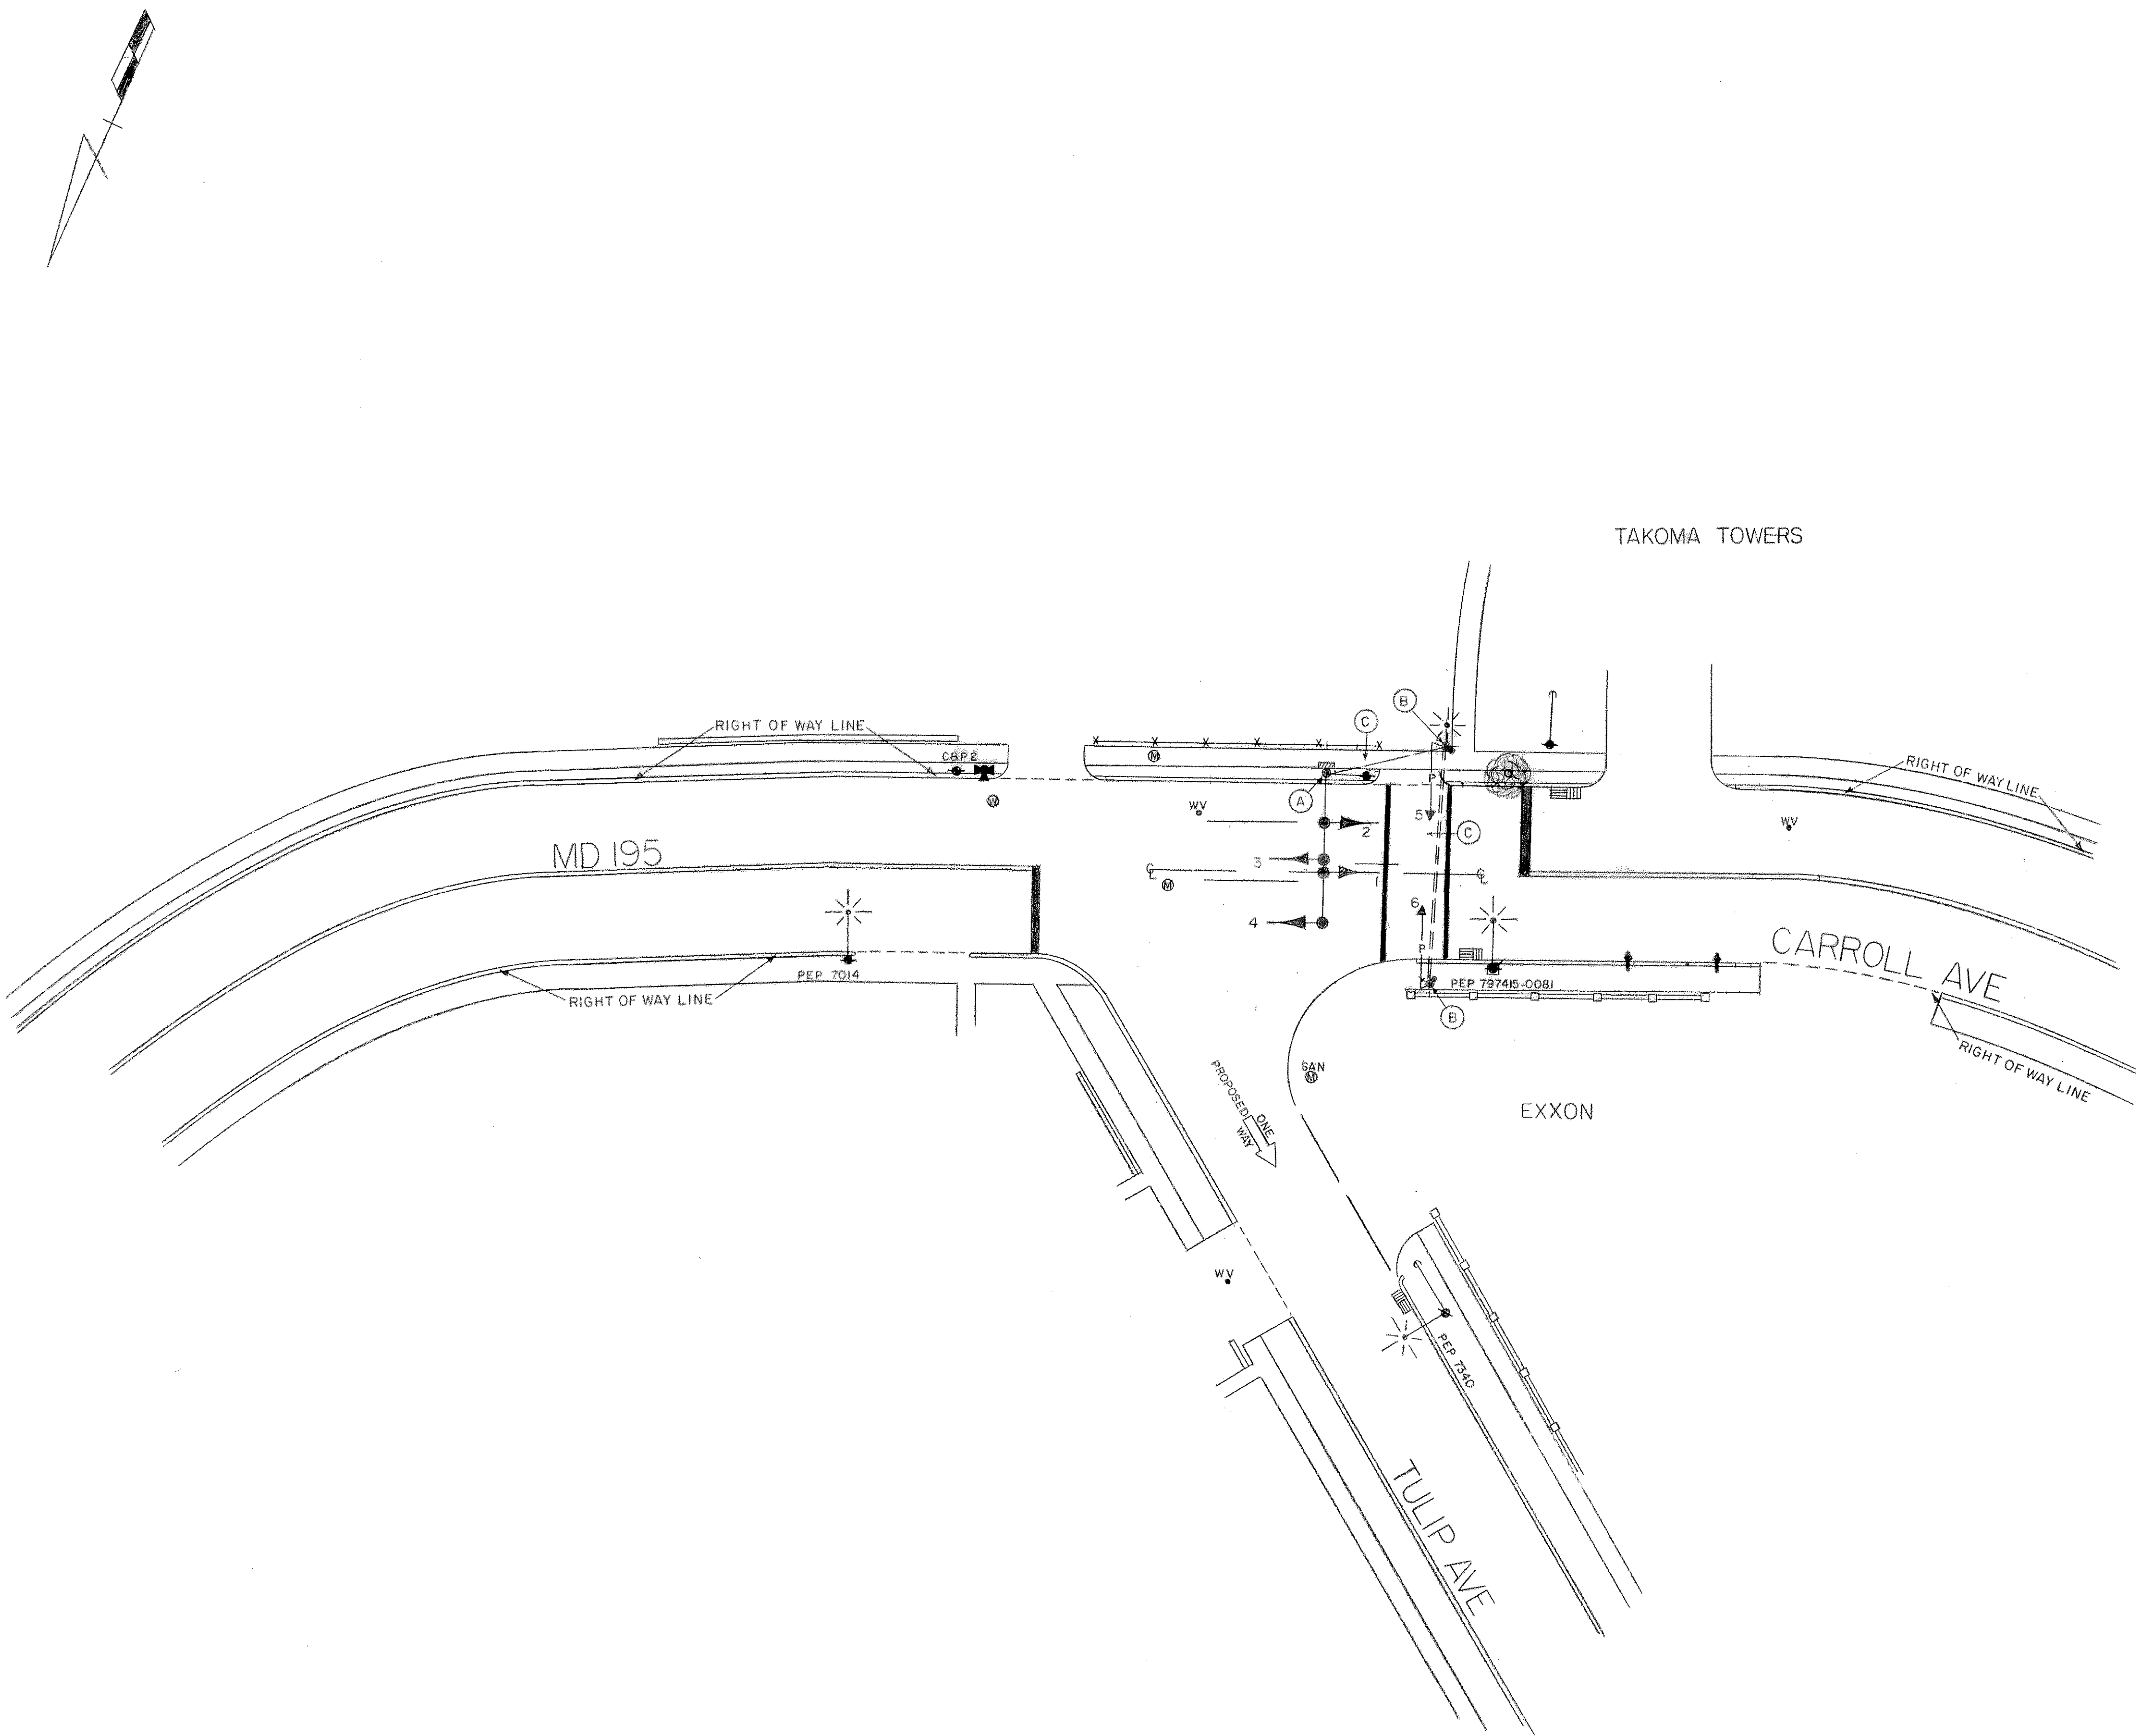


F.H.W.A. REGION NO.	STATE	FED. AID PROJ. NO.	SHEET NO.	TOTAL SHEETS
3	MD.			

SIGNALS

1-4	5,6
R	DW
Y	WK
G	

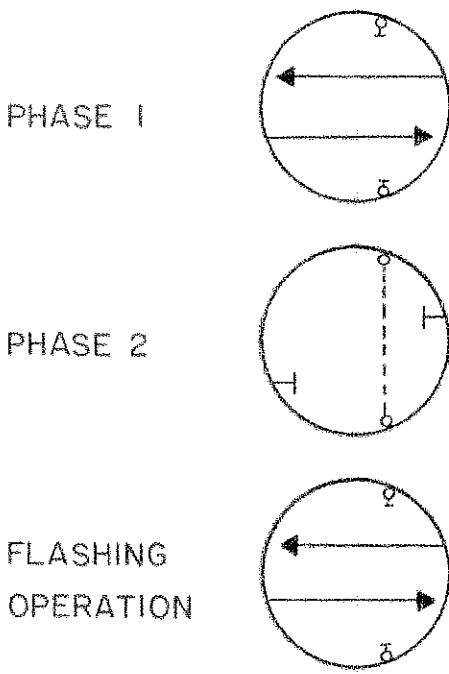

APPROVAL: REGIONAL TRAFFIC ENGINEER	
APPROVAL: CHIEF-BUREAU OF TRAFFIC ENGINEERING	
APPROVAL: <i>J. G. Gordon</i> 7-1-75 ASST. CHIEF ENGINEER TRAFFIC	<div> <div>A</div> <div>MAR. 16 1981</div> <div>ASBUILT</div> <div>J G <i>JG</i></div> </div>
	REVISIONS

STATE OF MARYLAND DEPARTMENT OF TRANSPORTATION STATE HIGHWAY ADMINISTRATION  TRAFFIC DIVISION — BUREAU OF TRAFFIC ENGINEERING  MD 195(CARROLL AVE)&TULIP AVE			
SCALE 1"=20'	DATE 12-23-74	CONTRACT NO. M 997X-000-385	
DRAWN BY: J. GORDON		COUNTY: MONTGOMERY	
DESIGNED BY: <i>J. Gordon</i>		SIGNAL NO.:	
CHECKED BY: <i>A. Budnick</i> 6/26/75.		DRAWING NO. TS-1249A	